


1 As Built Ground Floor Plan

Ground Floor Area: 3500 sq.ft. [325.2m²]

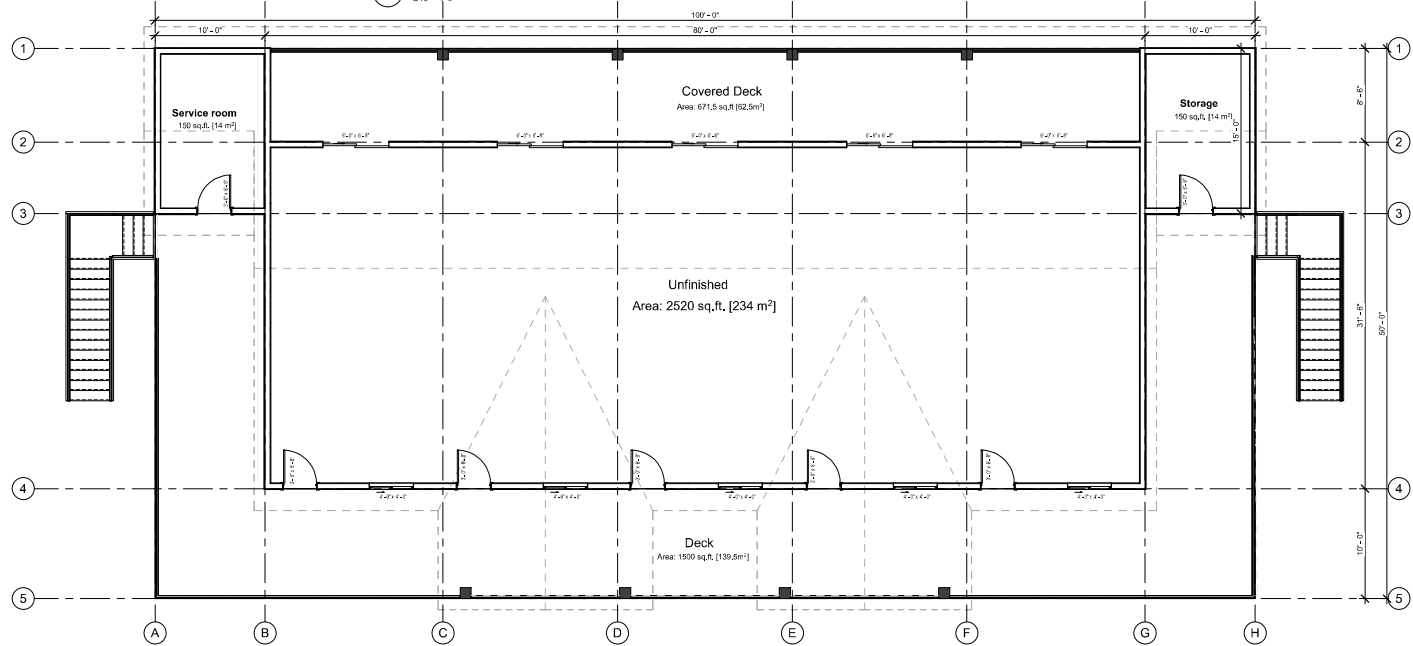


2 As-built Upper Floor Plan

Note: All existing dimensions to be confirmed on site.

1	April 2, 2024	For Permit
#	Date	Description
Revision Schedule		
Copyright		
This drawing is the property of Longview Design Studio. Reproduction by any means in part or whole is prohibited. This plan is only to be used for construction of the project below exclusively. Copyright reserved.		
Company Information		
Longview design studio Ph: 604-596-3988 kelenia@mail.com		
Project Information		
Agri-tourism accommodation 5154 Highway 97, 437 Rd 7, Oliver, BC		
File	24-07	
Sheet Name		
As-Built Floor Plans		
Drawn	Sheet	
EK		A2.0
Checked		
AK		
Date	Revision	
March 11, 2024		1

5/2/2024 8:07:53 AM

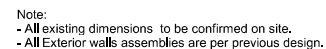

#	Date	Description
Revision Schedule		
copyright		
<p>This drawing is the property of Longview Design Studio. Reproduction by any means in part or whole is prohibited. This plan is only to be used for construction if the project below actually. Copyright reserved.</p>		
company information		
<p>Longview design studio Ph: 041 908 3588 kate@lgsd.com</p>		
project information		
<p>Agri-tourism accommodation 5154 Highway 97, 437 Rd. T, Oliver, BC</p>		
#	Date	
sheet 24/27		
<p>Proposed Upper Floor Plan</p>		
drawn BK	sheet	A3.0
checked AK		
date	revision	
March 11, 2024		
		1